


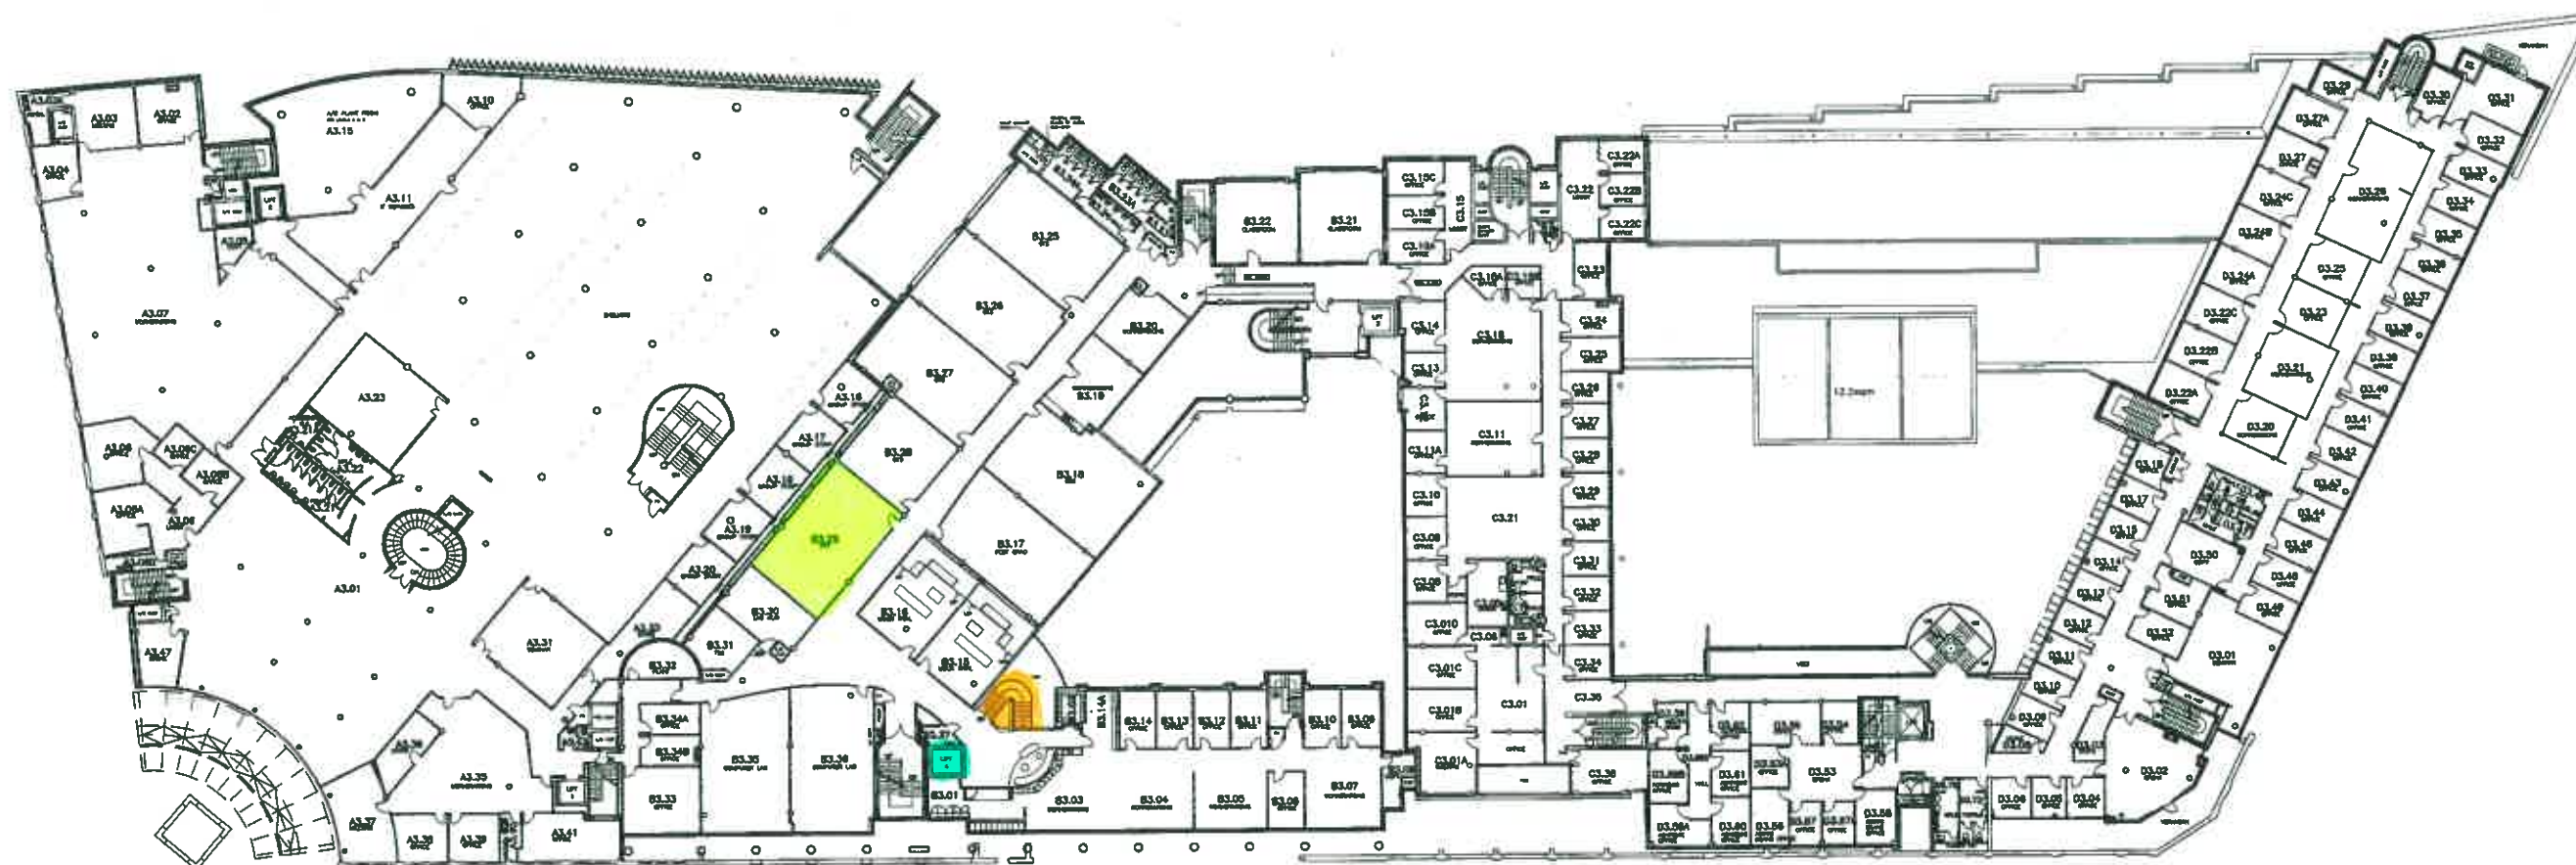


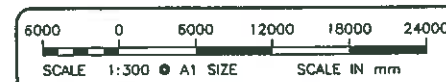

CITY MARKETS HAYMARKET, BUILDING 5 LEVEL 03

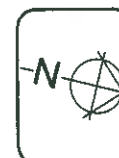

Rev 1 REVIEWED AND UPDATED.

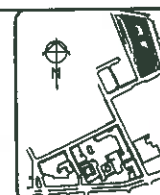

Facilities Management Unit

AS BUILT APRIL 2012

CM0503AP-04586_01

REVISION IN PROGRESS

